



C. Earl Hunter, Commissioner

*Promoting and protecting the health of the public and the environment.*

## **PUBLIC NOTICE AMENDMENT REQUEST**

The permittee for P/N# **OCRM-06-964, Rebecca A Davis**, has requested an amendment to that issued permit. Specifically, the applicant proposes to increase the walkway length from 98' to 123', move boatlift from flood side to ebb side of pierhead and deck boatlift cradle to accommodate kayaks. The proposed amendment is for modifications to a private dock located on and adjacent to Huspah Creek at 33 Butler Farm Road, Seabrook, Beaufort County, South Carolina.

Written comments will be received on this amendment request until September 8, 2008 at the address listed below. For further information please contact the project manager, **Geordie J. Madlinger, 843-846-9400.**


August 29, 2008

**SOUTH CAROLINA DEPARTMENT OF HEALTH AND ENVIRONMENTAL CONTROL**


**Ocean and Coastal Resource Management**

**Charleston Office • 1362 McMillan Avenue, Suite 400 • Charleston, SC 29405**

**Phone: 843-953-0200 • Fax: 843-953-0201 • [www.scdhec.gov](http://www.scdhec.gov)**

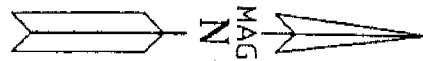

DOCK AS-BUILT  
PREPARED FOR  
REBECCA DAVIS  
33 BUTLER FARM RD.  
SEABROOK, SC 29940

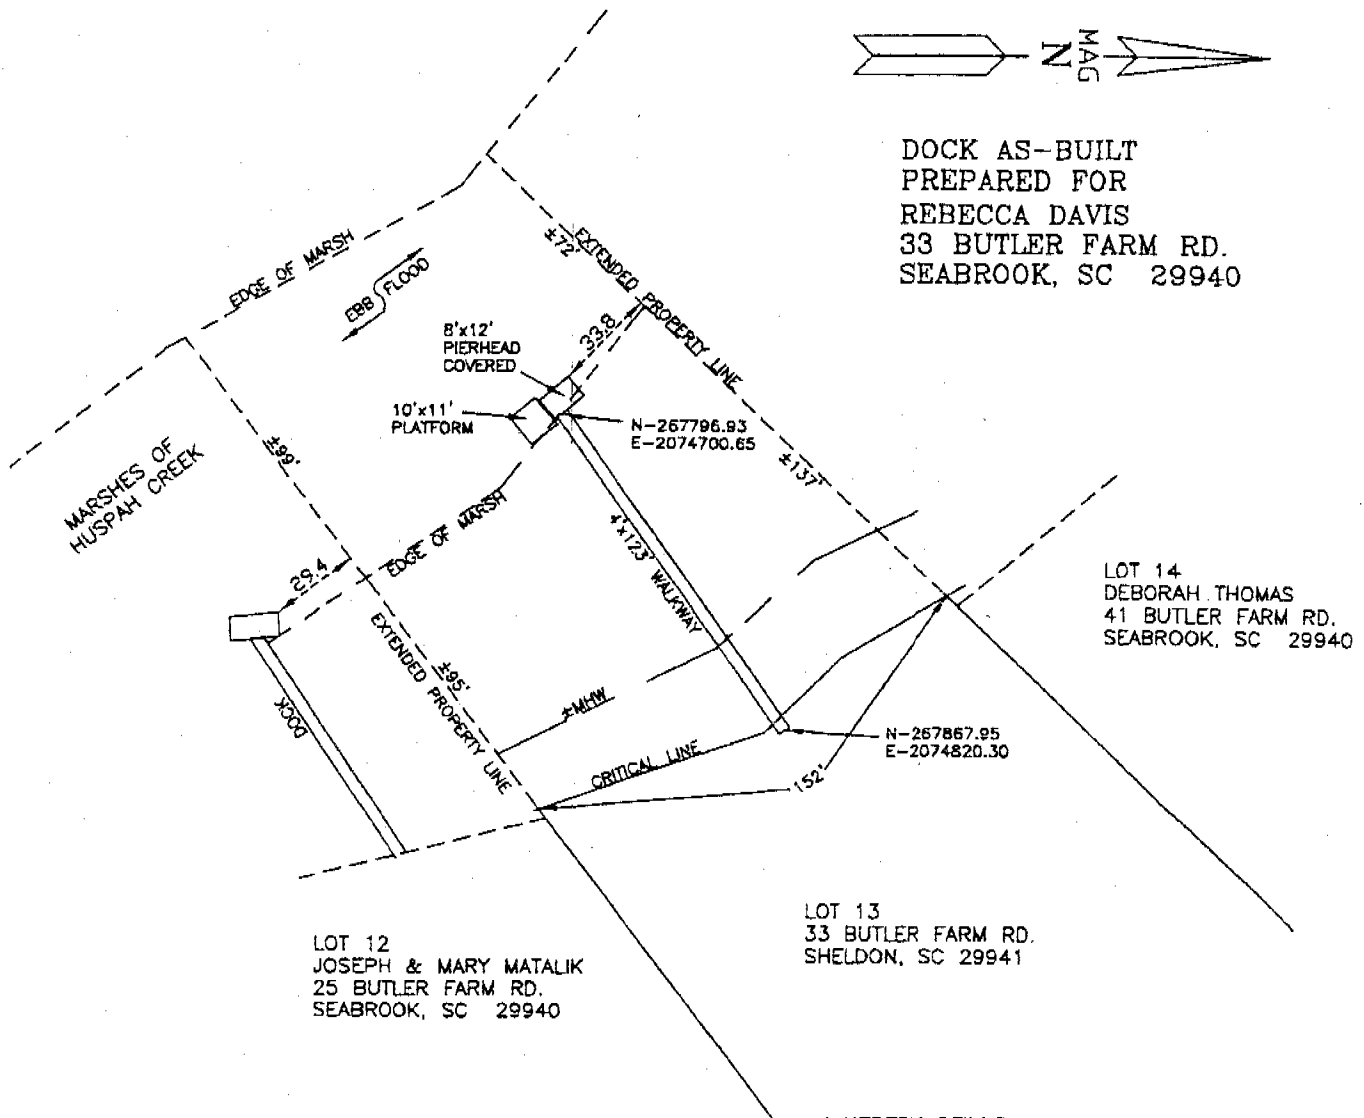

I HEREBY CERTIFY TO THE DIMENSIONS SHOWN  
ON THIS SKETCH THAT PERTAIN TO CRITICAL LINE  
AND MARSH LINE.

R700-027-000-0066-0000


0 30' 60' 120' 180'

SCALE 1" = 60'

AUGUST 8, 2008

P13856DS/MMA

OC RM. 06-964

  
DAVID S. YOUMANS RLS 9765  
BEAUFORT SURVEYING, INC.  
1613 PARIS AVENUE  
PORT ROYAL, S.C. 29935  
PHONE (843) 524-3261

APPLICANT: REBECCA DAVIS

ACTIVITY: DOCK AS-BUILT

LOCATION: GLADYS W. BUTLER S/D  
SEABROOK, SC

COUNTY: BEAUFORT


DATE: 08/08/08

ADJACENT PROPERTY OWNERS

JOSEPH & MARY MATALIK - LOT 12

DEBORAH THOMAS - LOT 14

DOCK AS-BUILT  
 PREPARED FOR  
 REBECCA DAVIS  
 33 BUTLER FARM RD.  
 SEABROOK, SC 29940

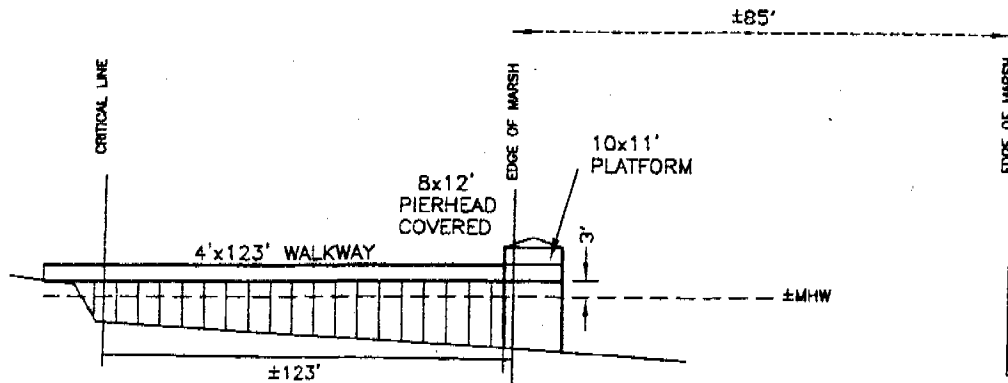

SIDE VIEW  
 NOT TO SCALE

R700-027-000-0066-0000

*David S. Youmans*  
 DAVID S. YOUMANS RLS 9765  
 BEAUFORT SURVEYING, INC.  
 1613 PARIS AVENUE  
 PORT ROYAL, S.C. 29935  
 PHONE (843) 524-3261

P13856DS/MMA

*OCRM-06-964*

APPLICANT: REBECCA DAVIS

ACTIVITY: DOCK AS-BUILT

LOCATION: GLADYS W. BUTLER S/D  
 SEABROOK, SC

COUNTY: BEAUFORT

DATE: 08/08/08

ADJACENT PROPERTY OWNERS

JOSEPH & MARY MATAUK - LOT 12

DEBORAH THOMAS - LOT 14